


- A. ALL WORK TO CONFORM TO ALL LOCAL, STATE AND FEDERAL CODES INCLUDING THE NEW ORLEANS BUILDING CODES (IRC 2012 AND IBC 2015) AND THE NEW ORLEANS HISTORIC DISTRICT LANDMARKS COMMISSION LOWER GARDEN DISTRICT.
- B. CONTRACTORS TO VERIFY ALL EXISTING CONDITIONS AND REPORT ALL CHANGES TO THE ARCHITECT AND OWNER.
- C. CONTRACTORS ARE RESPONSIBLE FOR ALL CONSTRUCTIONS METHODS, MEANS, SCHEDULES, SAFETY AND EQUIPMENT AND MATERIALS.
- D. CONTRACTORS TO REMOVE ALL DAMAGED MATERIALS AND DEBRIS FROM SITE.

- 1 REPLACE ALL MISSING OR DAMAGED WEATHER BOARDS TO MATCH PRIME AND PAINT
- 2 REMOVE ALL VEGETATION FROM WALLS AND ROOFS
- 3 INSTALL NEW WOOD PANELED DOOR AND HARDWARE TO MATCH EXISTING-PRIME AND PAINT
- 4 REPLACE DOUBLE HUNG WINDOW SASHES TO MATCH EXISTING-PRIME AND PAINT
- 5 ~~INSTALL NEW 1X HARD-BOARD FASCIA AT EXISTING RAFTER ENDS-PRIME AND PAINT~~
- 6 INSTALL NEW 6" HALF ROUND GUTTERS AND 6" DOWNSPOUTS

**FRONT**

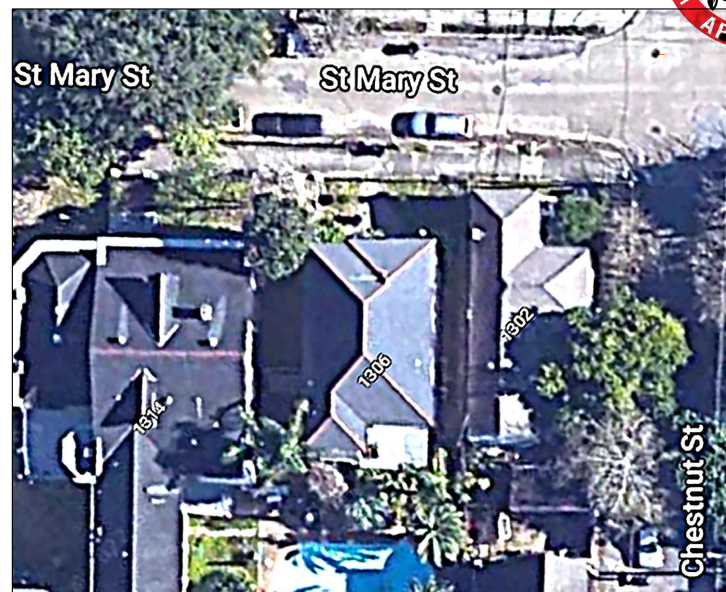

## RIGHT SIDE

Copyright ©  
Donald Macinnis Architect, Inc.

**EXTERIOR REPAIRS**  
1306 ST MARY STREET  
NEW ORLEANS, LA 70130

[illegible]

SHEET: ENTRY
SCALE: VARIES
DRAWN BY: FA

A-1  
1 OF 1





NEW DOOR INSTALLED WITHOUT  
CERTIFICATE OF APPROPRIATENESS IS OK;  
APPROVED AS INSTALLED

